PAGE 19

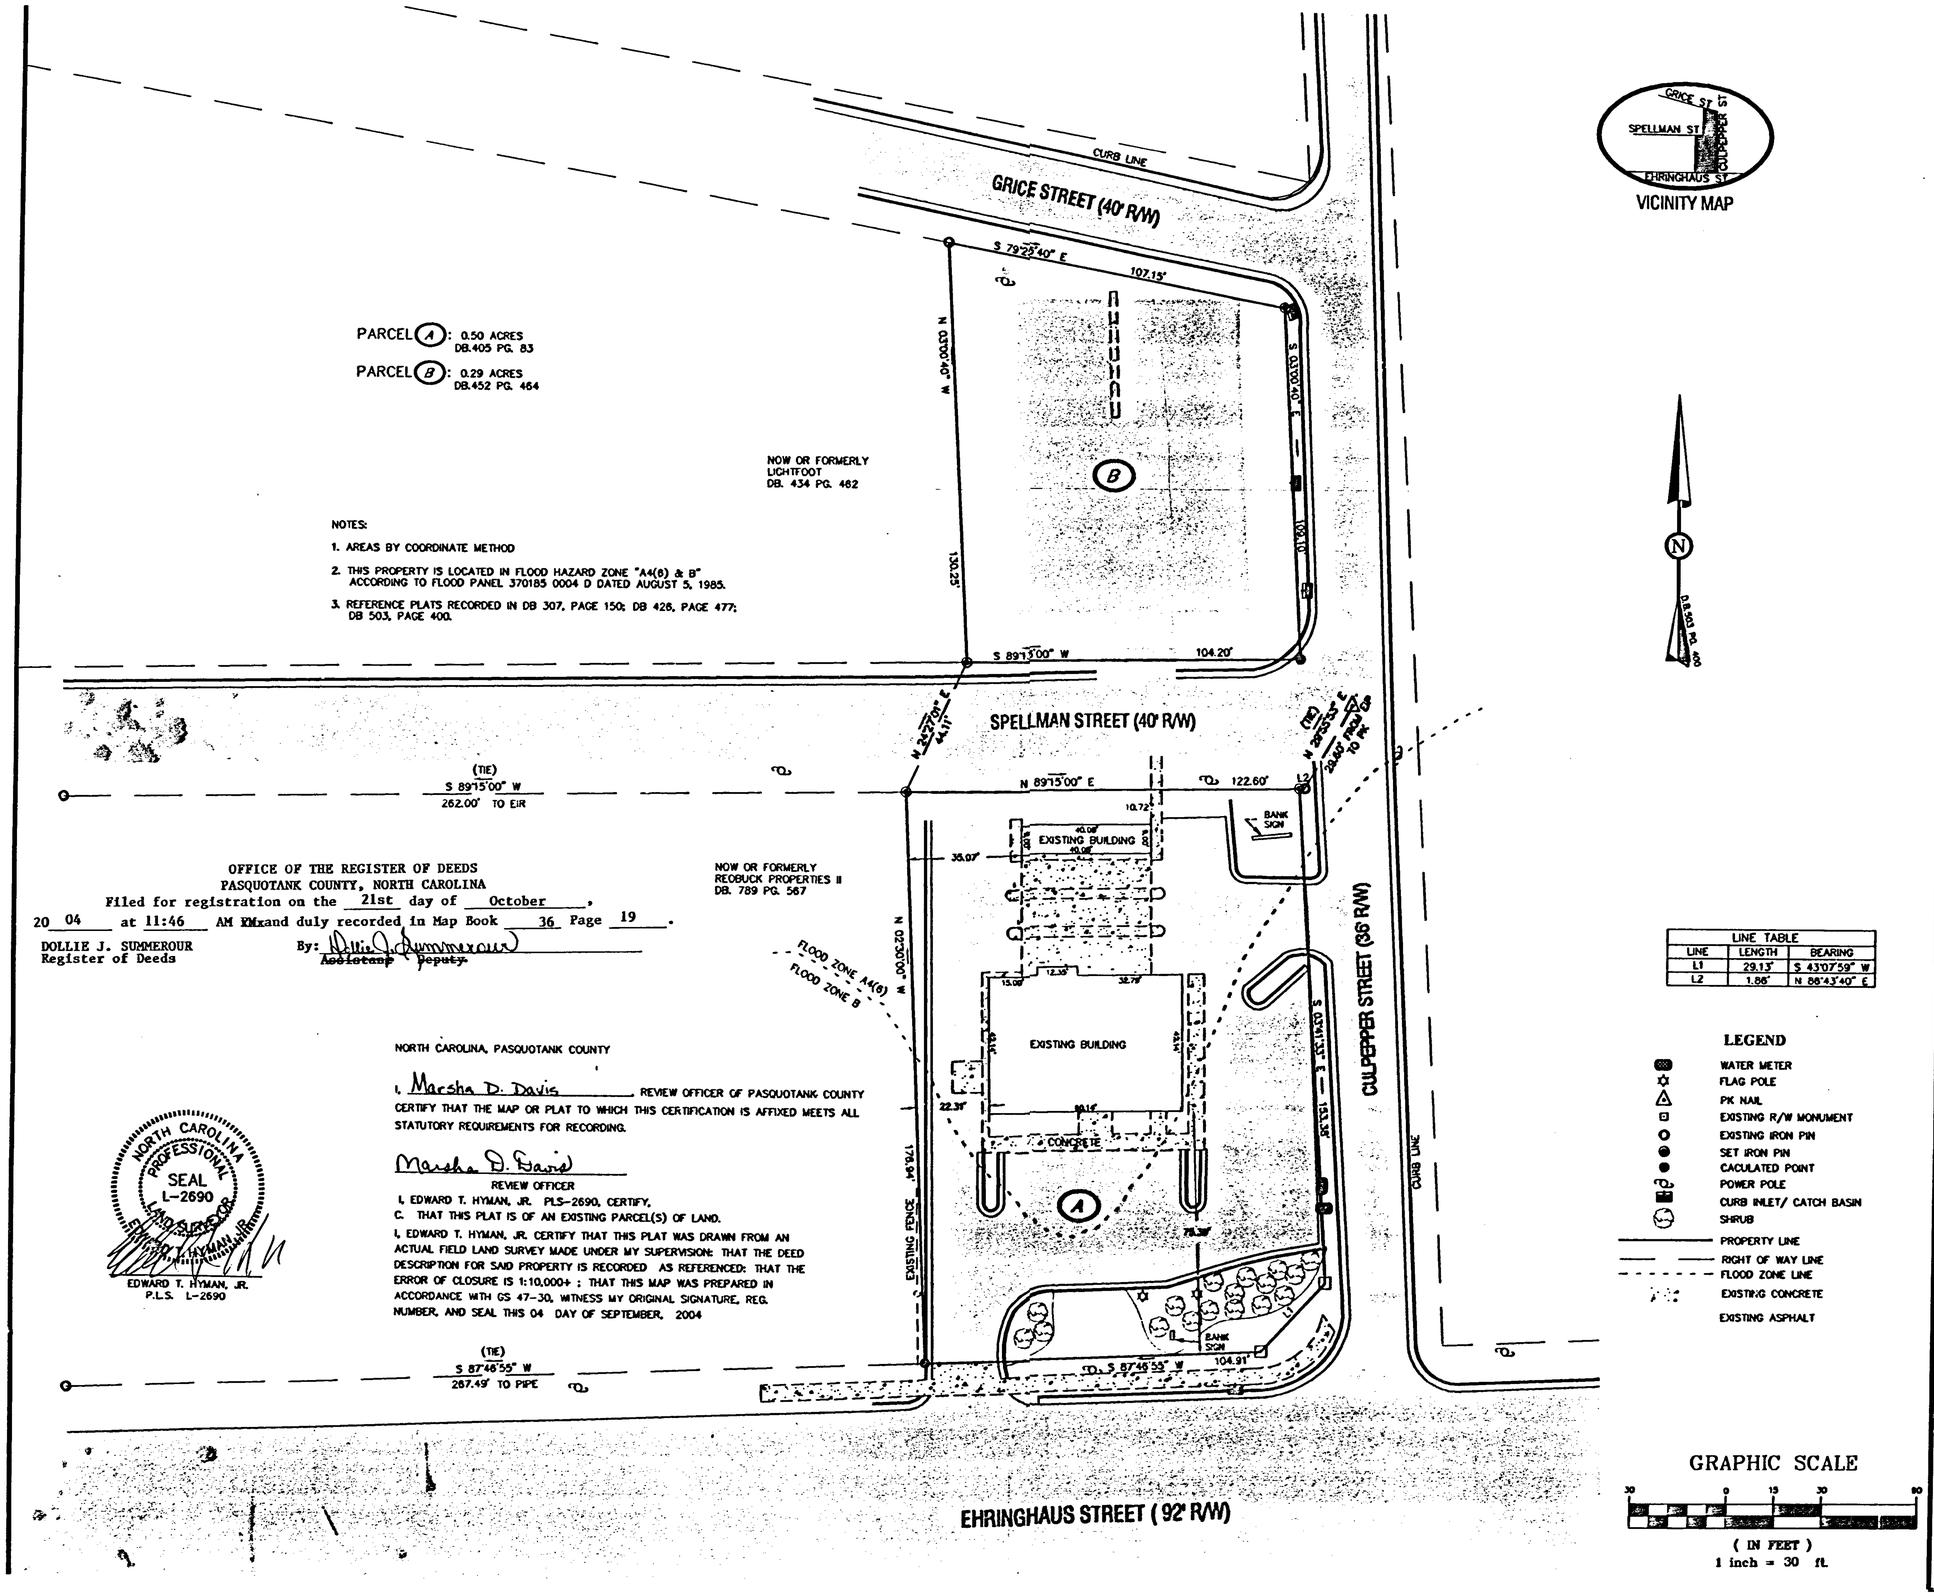

OFFICE OF THE REGISTER OF DEEDS
PASQUOTANK COUNTY, NORTH CAROLINA
Filed for registration on the 21st day of October,
20 04 at 11:46 AM XMxand duly recorded in Map Book 36 Page 19.
DOLLIE J. SUMMEROUR
Register of Deeds
By: Dollie J. Summerour
~~Assistant~~ ~~Deputy~~

NORTH CAROLINA, PASQUOTANK COUNTY

I, Marsha D. Davis, REVIEW OFFICER OF PASQUOTANK COUNTY CERTIFY THAT THE MAP OR PLAT TO WHICH THIS CERTIFICATION IS AFFIXED MEETS ALL STATUTORY REQUIREMENTS FOR RECORDING.

Marsha D. Davis
REVIEW OFFICER

I, EDWARD T. HYMAN, JR. PLS-2690, CERTIFY,
C. THAT THIS PLAT IS OF AN EXISTING PARCEL(S) OF LAND.
I, EDWARD T. HYMAN, JR. CERTIFY THAT THIS PLAT WAS DRAWN FROM AN ACTUAL FIELD LAND SURVEY MADE UNDER MY SUPERVISION: THAT THE DEED DESCRIPTION FOR SAID PROPERTY IS RECORDED AS REFERENCED: THAT THE ERROR OF CLOSURE IS 1:10,000+ ; THAT THIS MAP WAS PREPARED IN ACCORDANCE WITH GS 47-30, WITNESS MY ORIGINAL SIGNATURE, REG. NUMBER, AND SEAL THIS 04 DAY OF SEPTEMBER, 2004

NORTH CAROLINA PROFESSIONAL SEAL L-2690 LAND SURVEYOR EDWARD T. HYMAN, JR.

EDWARD T. HYMAN, JR.
P.L.S. L-2690

PHYSICAL SURVEY FOR GATEWAY BANK

ELIZABETH CITY TOWNSHIP
PASQUOTANK COUNTY
NORTH CAROLINA

Hyman & Robey PC
Land Surveyors & Consulting Engineers
150 A US HWY 158 E
Camden, North Carolina 27921
(252) 338-2913 (252) 335-1888

DATE: 9/04/2004	DRAWN: LJC
CHECKED: ETH	APPROVED: ETH
SCALE: 1": 30'	PROJECT # 040722
DRAWING # 040722	
SHEET # 1 OF 1	

COPYRIGHT © 2003

S:\Hyman & Robey 04\040722- Kelly, Jerry\dwg\040722.dwg, Model, 10/11/2004 12:19:39 PM, 1:30, RW1